




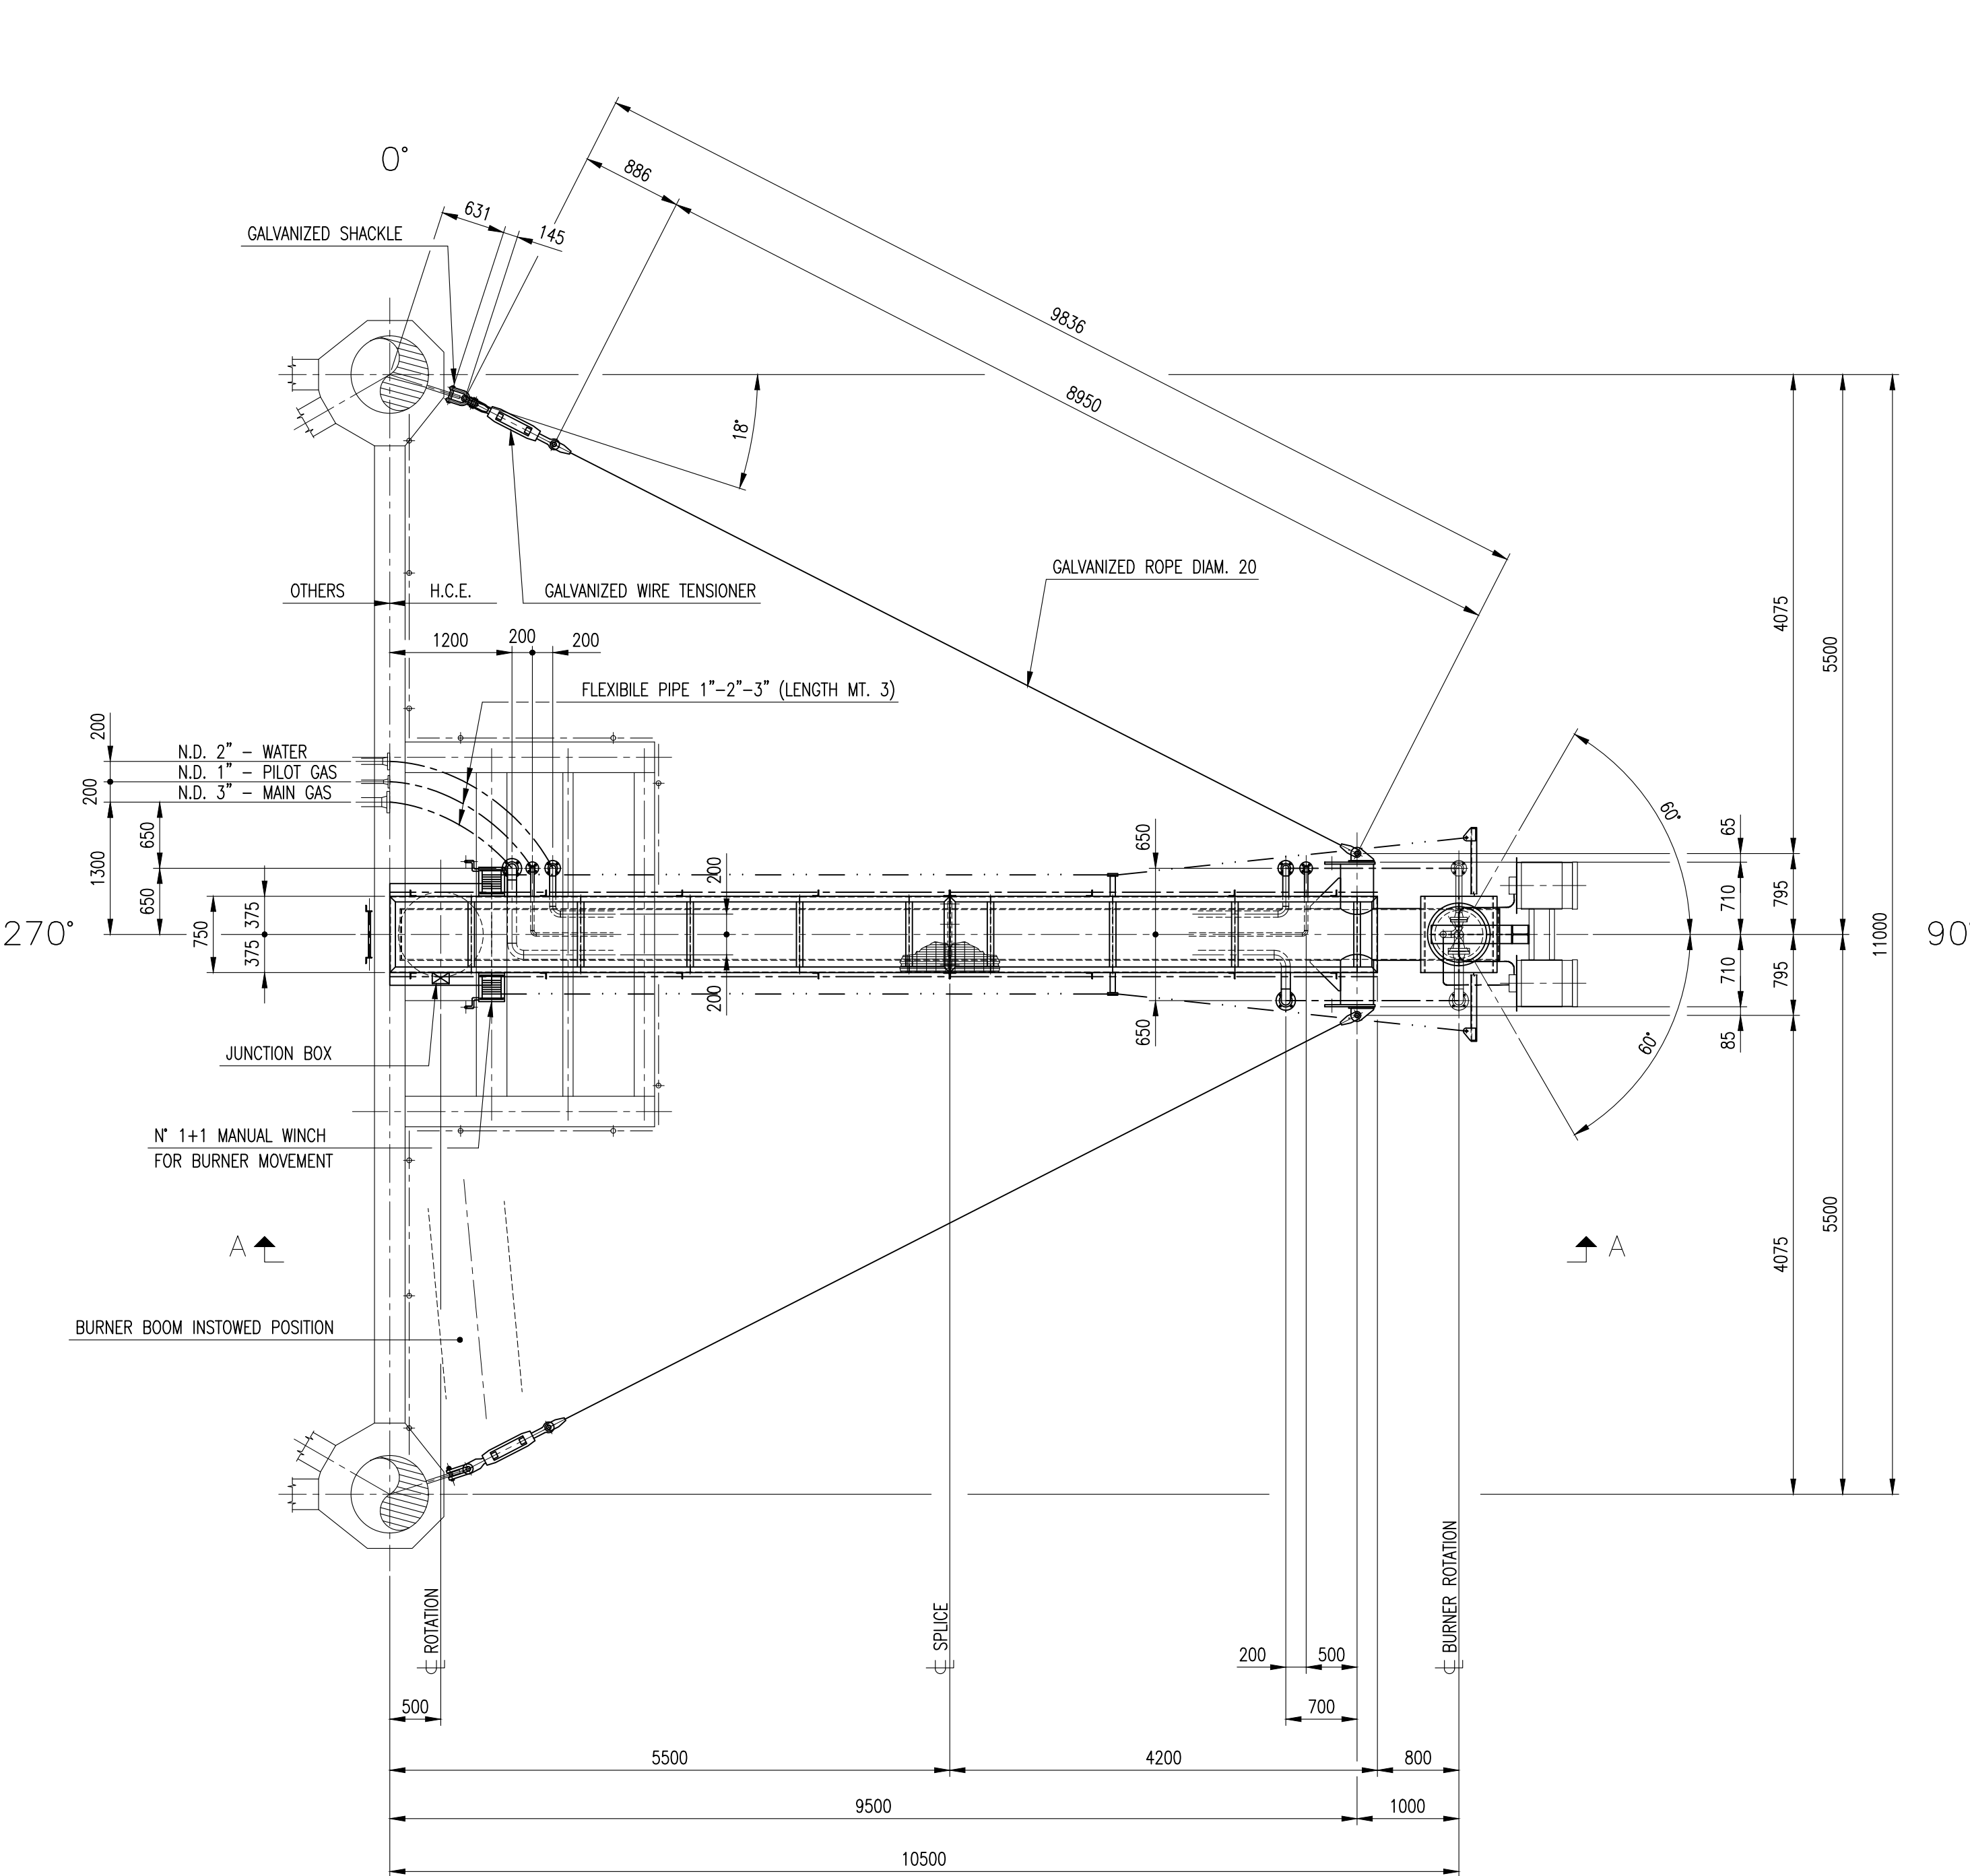

PLAN

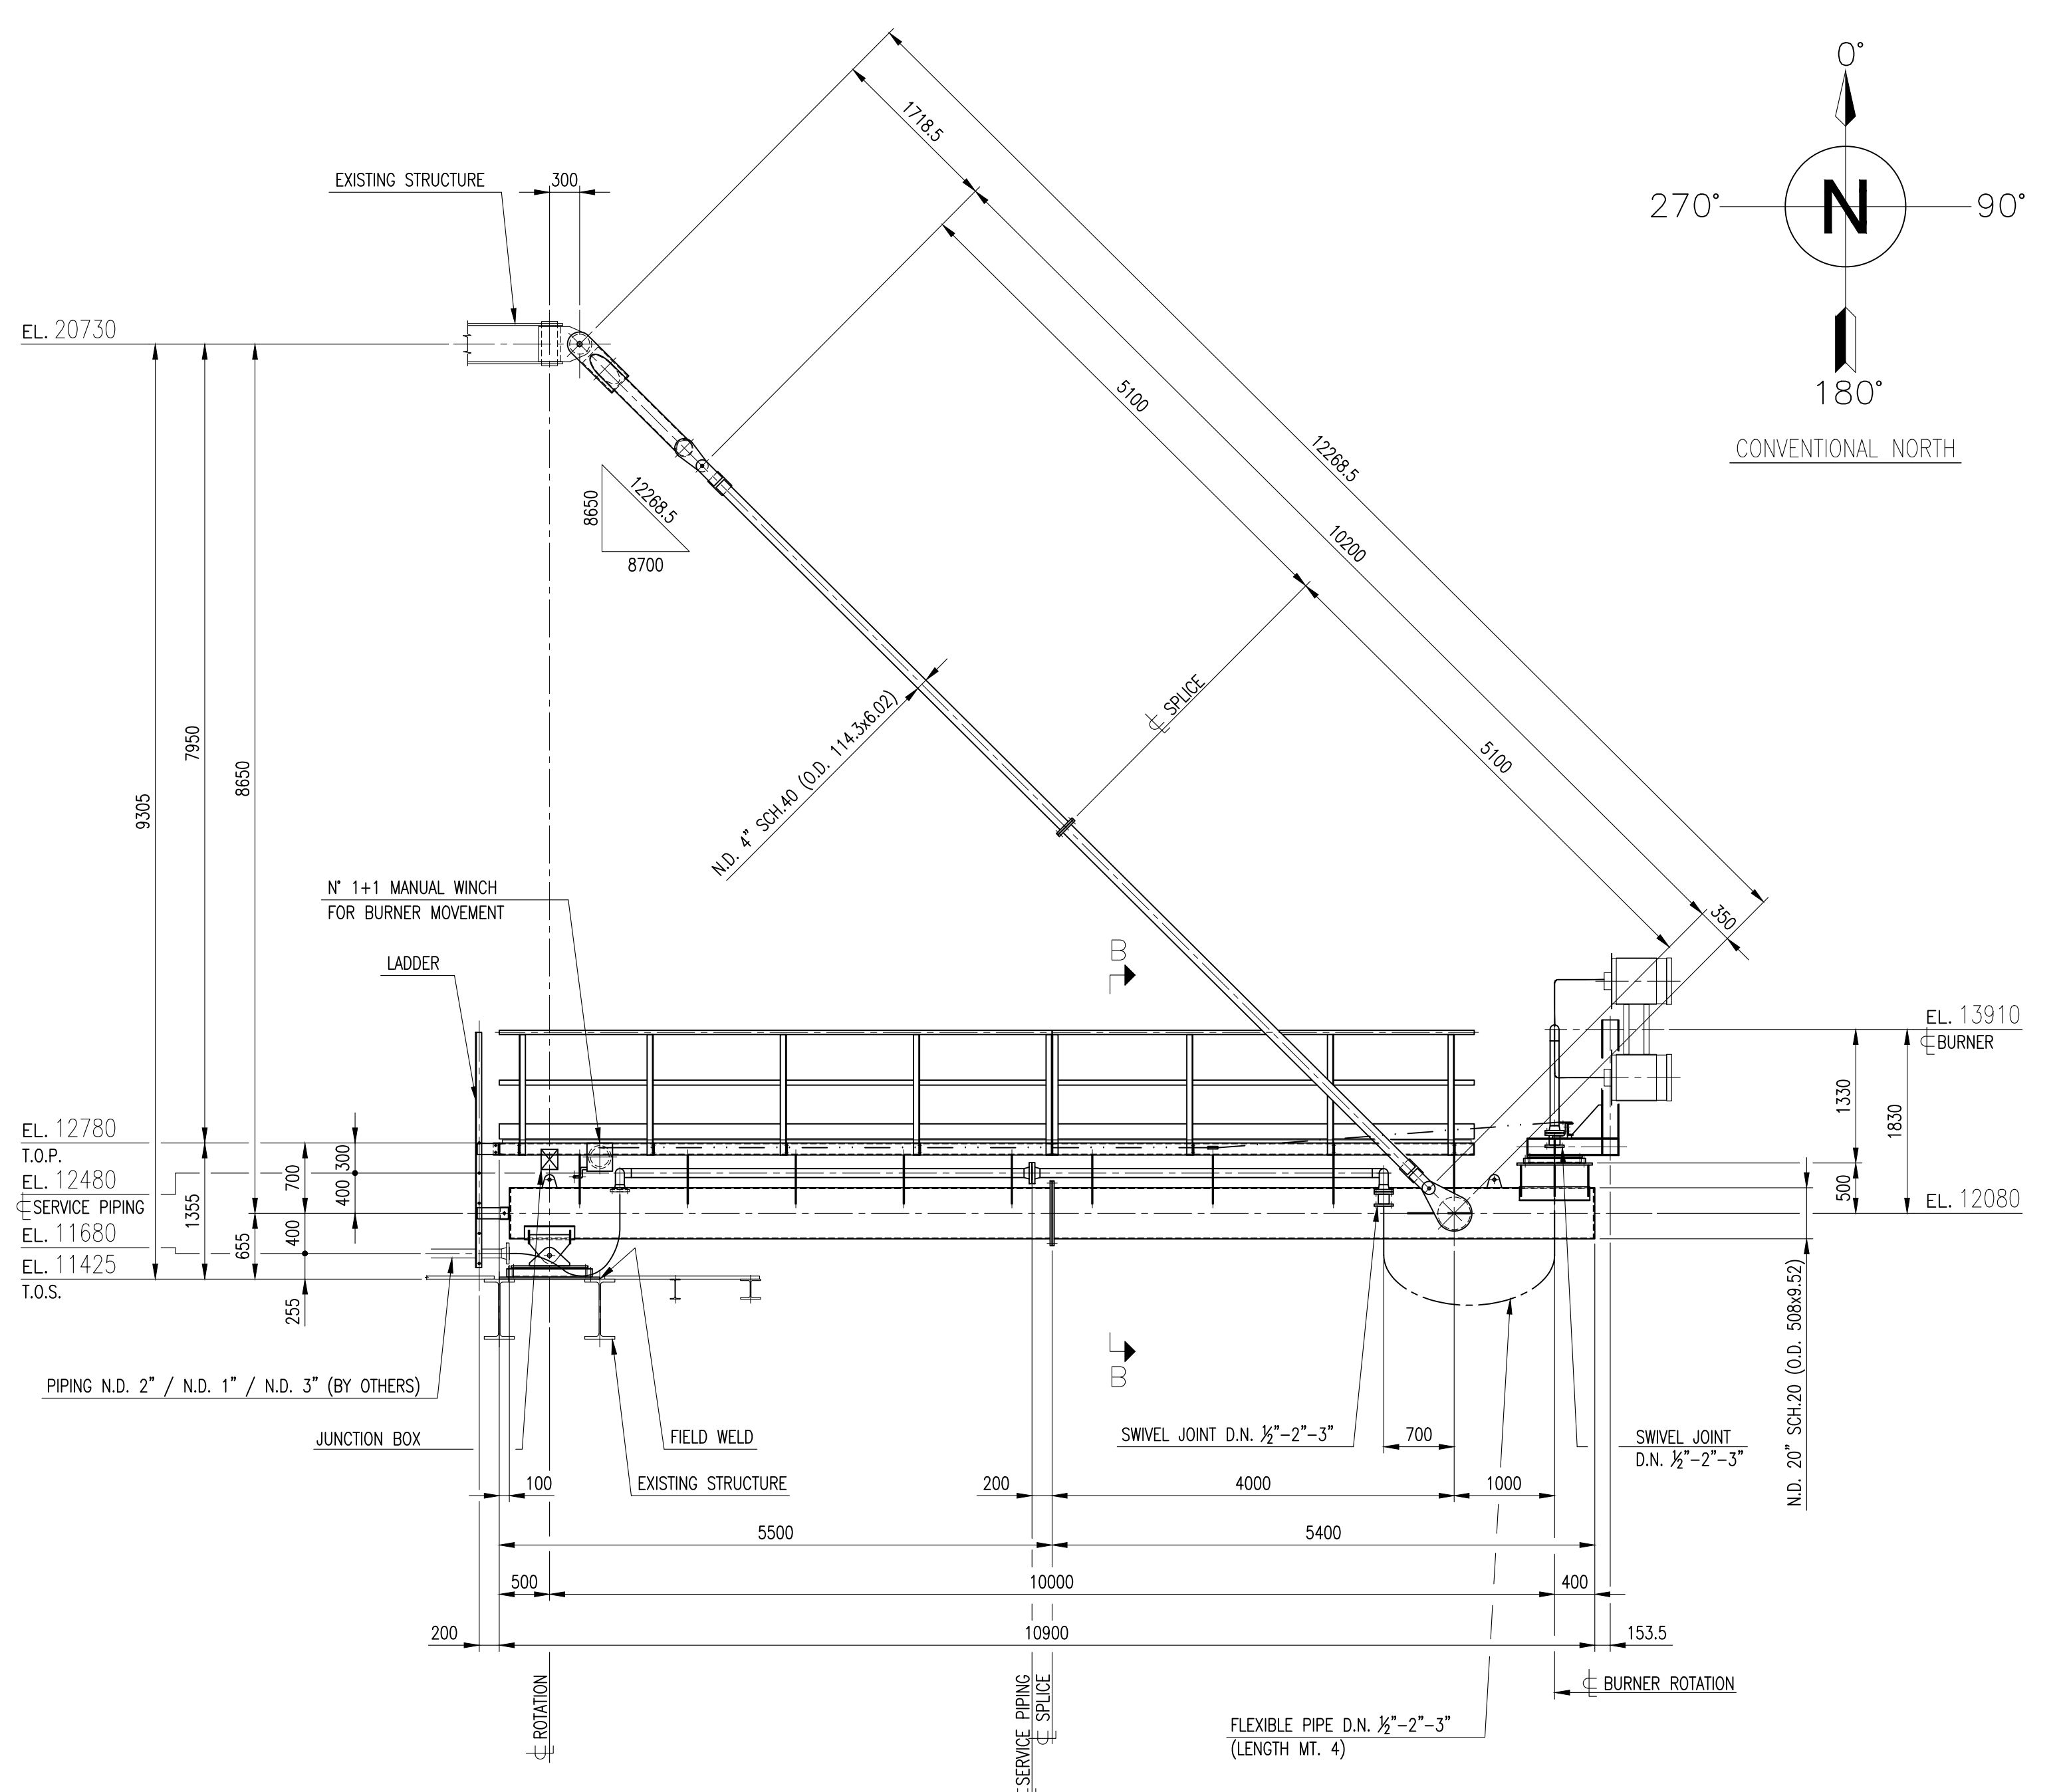


VIEW A-A

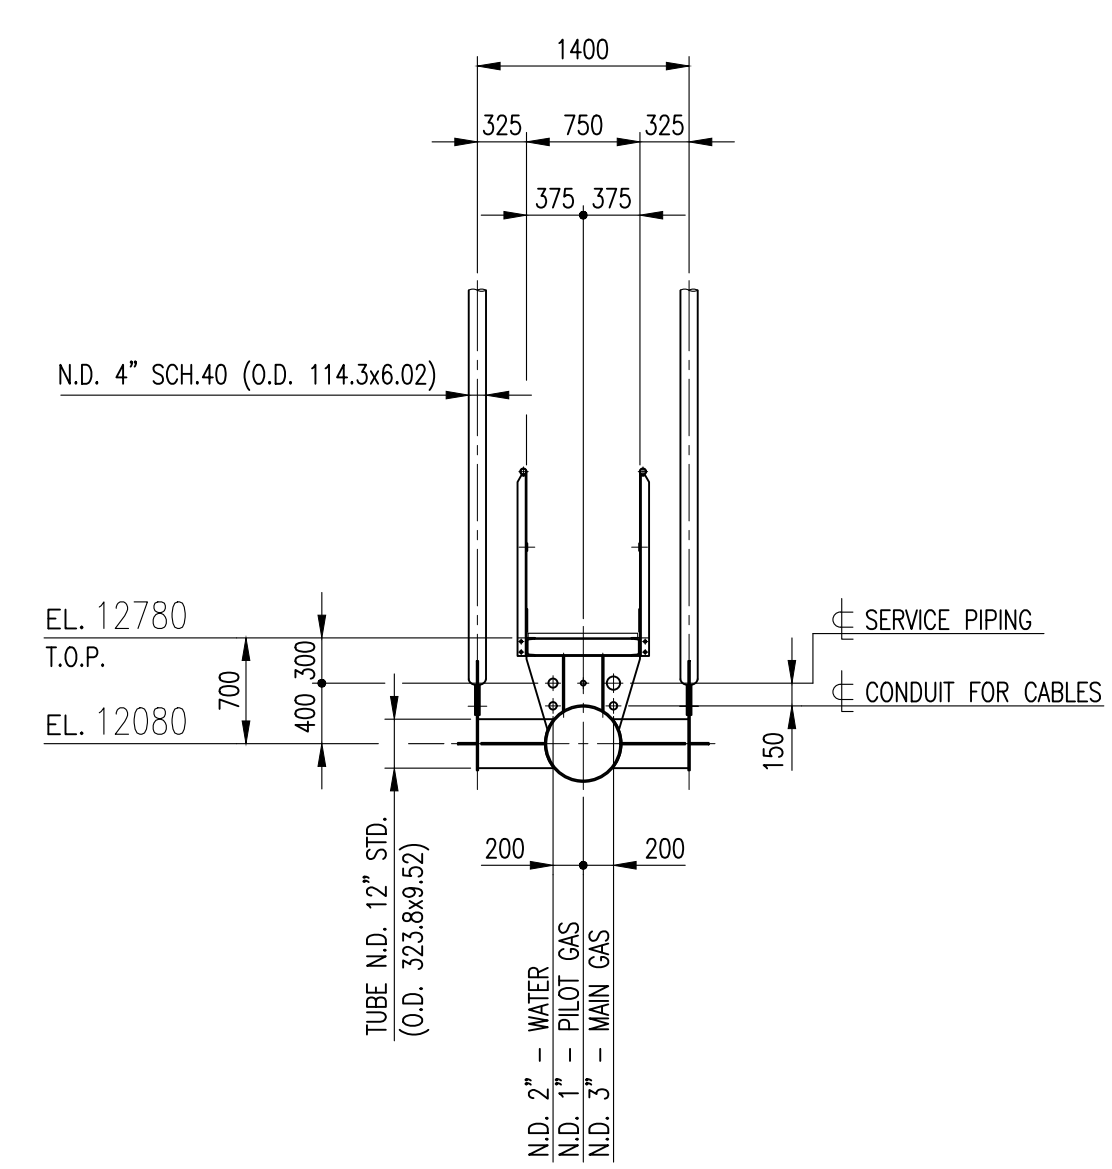

SECTION B-B

- NOTES**
- 1) ALL DIMENSIONS ARE IN MILLIMETRES (UNLESS OTHERWISE SPECIFIED), ANGLES IN DEGREES
 - 2) NOZZLE AND FLANGE BOLT HOLES SHALL BE STRADDLED ON THE CENTERLINE OF UNIT
 - 3) FOR MATERIAL OF CONSTRUCTION REFER TO INDIVIDUAL DETAILED DRAWINGS
 - 4) FOR DETAILED INFORMATION SEE CONSTRUCTION DRAWINGS

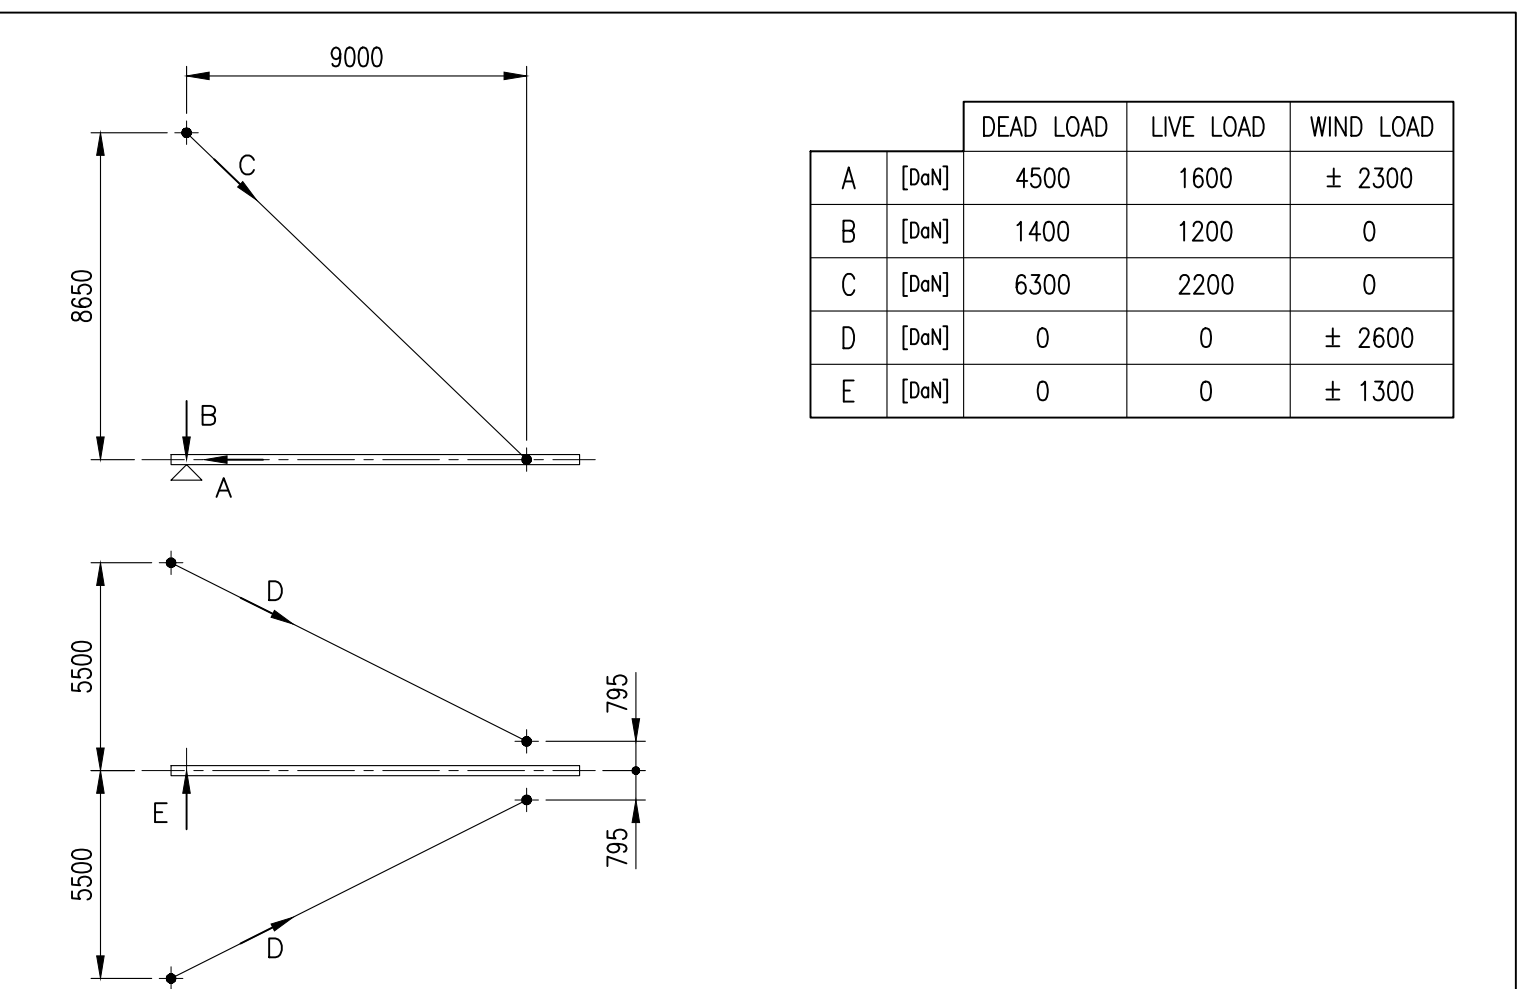

REFERENCE DRAWINGS		
ITEM	DESCRIPTION	DRAWING NUMBER
A	BURNER GENERAL (ASSEMBLY)	1492-101
B	BOOM STRUCTURE (ASSEMBLY)	1492-105
C	BOOM STRUCTURE (DETAILS)	1492-105-1
D	PLATFORM AND LADDER	1492-106
E	STAY-BARS	1492-107

SERVICE PIPING LIST			
POS.	SERVICE	SIZE	RATING
1	MAIN GAS	3"	WN.RF. - ANSI 16.5 150 Lb
2	PILOT GAS	1"	WN.RF. - ANSI 16.5 150 Lb
3	WATER	2"	WN.RF. - ANSI 16.5 150 Lb

TORCIA SCARICO GAS

SU PIATTAFORME MARINE

COMM. A.E. C 340-02

TOTAL SOUTH PARS
SOUTH PARS FIELD DEVELOPMENT (PHASES TWO & THREE)
CONTRACT N°TSP/PJ/011
WELLHEAD PLATFORMS WP1 & WP2

JOB Nr : ***

2	16.01.2003	AS BUILT	A.E.	E.G.	D.B.
1	10.12.2002	ISSUED FOR CONSTRUCTION	A.E.	E.G.	D.B.
0	29.11.2002	ISSUED FOR APPROVAL	A.E.	E.G.	D.B.
REV.	DATE	DESCRIZIONE	DESIGNATO	CONTROLLATO	APPROVATO
CLIENTE	TOTAL FINA ELF	PIANTO PLANT	WELL HEAD PLATFORMS WP1 & WP2		
ORIGINE ORDER	TSP - 10167	LOCALITA' LOCALITY	IRAN		

Hamworthy Combustion Engineering S.r.l.
20035 LISSONE (MI) - VIA GRAMSCI, 11 - ITALY - Tel. 039/2459049 - Telefax 039/2459069

SCALE
1:50

DATA DATE
29.11.2002

DESCRIZIONE DESCRIPTION
WET LIQUID BURNERS FOR WELLHEAD PLATFORMS WP1 & WP2
GENERAL ARRANGEMENT

MS. REF. OUR REF.
ITT 1492
1492-100

DESIGNATO PREPARED
CONTROLLATO CHECKED
APPROVATO APPROVED

A.E.
E.G.
D.B.

ALFA ENGINEERING
Consulenza e Progettazione dal 1983

Hamworthy Combustion Engineering S.r.l.

WET LIQUID BURNERS FOR WELLHEAD PLATFORMS WP1 & WP2

GENERAL ARRANGEMENT

This drawing and information are property of Alfa Engineering s.a.s. and are not to be reproduced, copied, lent or disclosed without written permission.

DWN. 29/11/02
CKD. -
APP. -

29/11/02
F.M.A.
ALFA ENG

A.E.
DWG. 34002-A1-100
SCALE: 1:50

C340-02-100-A1-R0
REV. 0